







69 Poles • 68 Spans • 22,090 ft

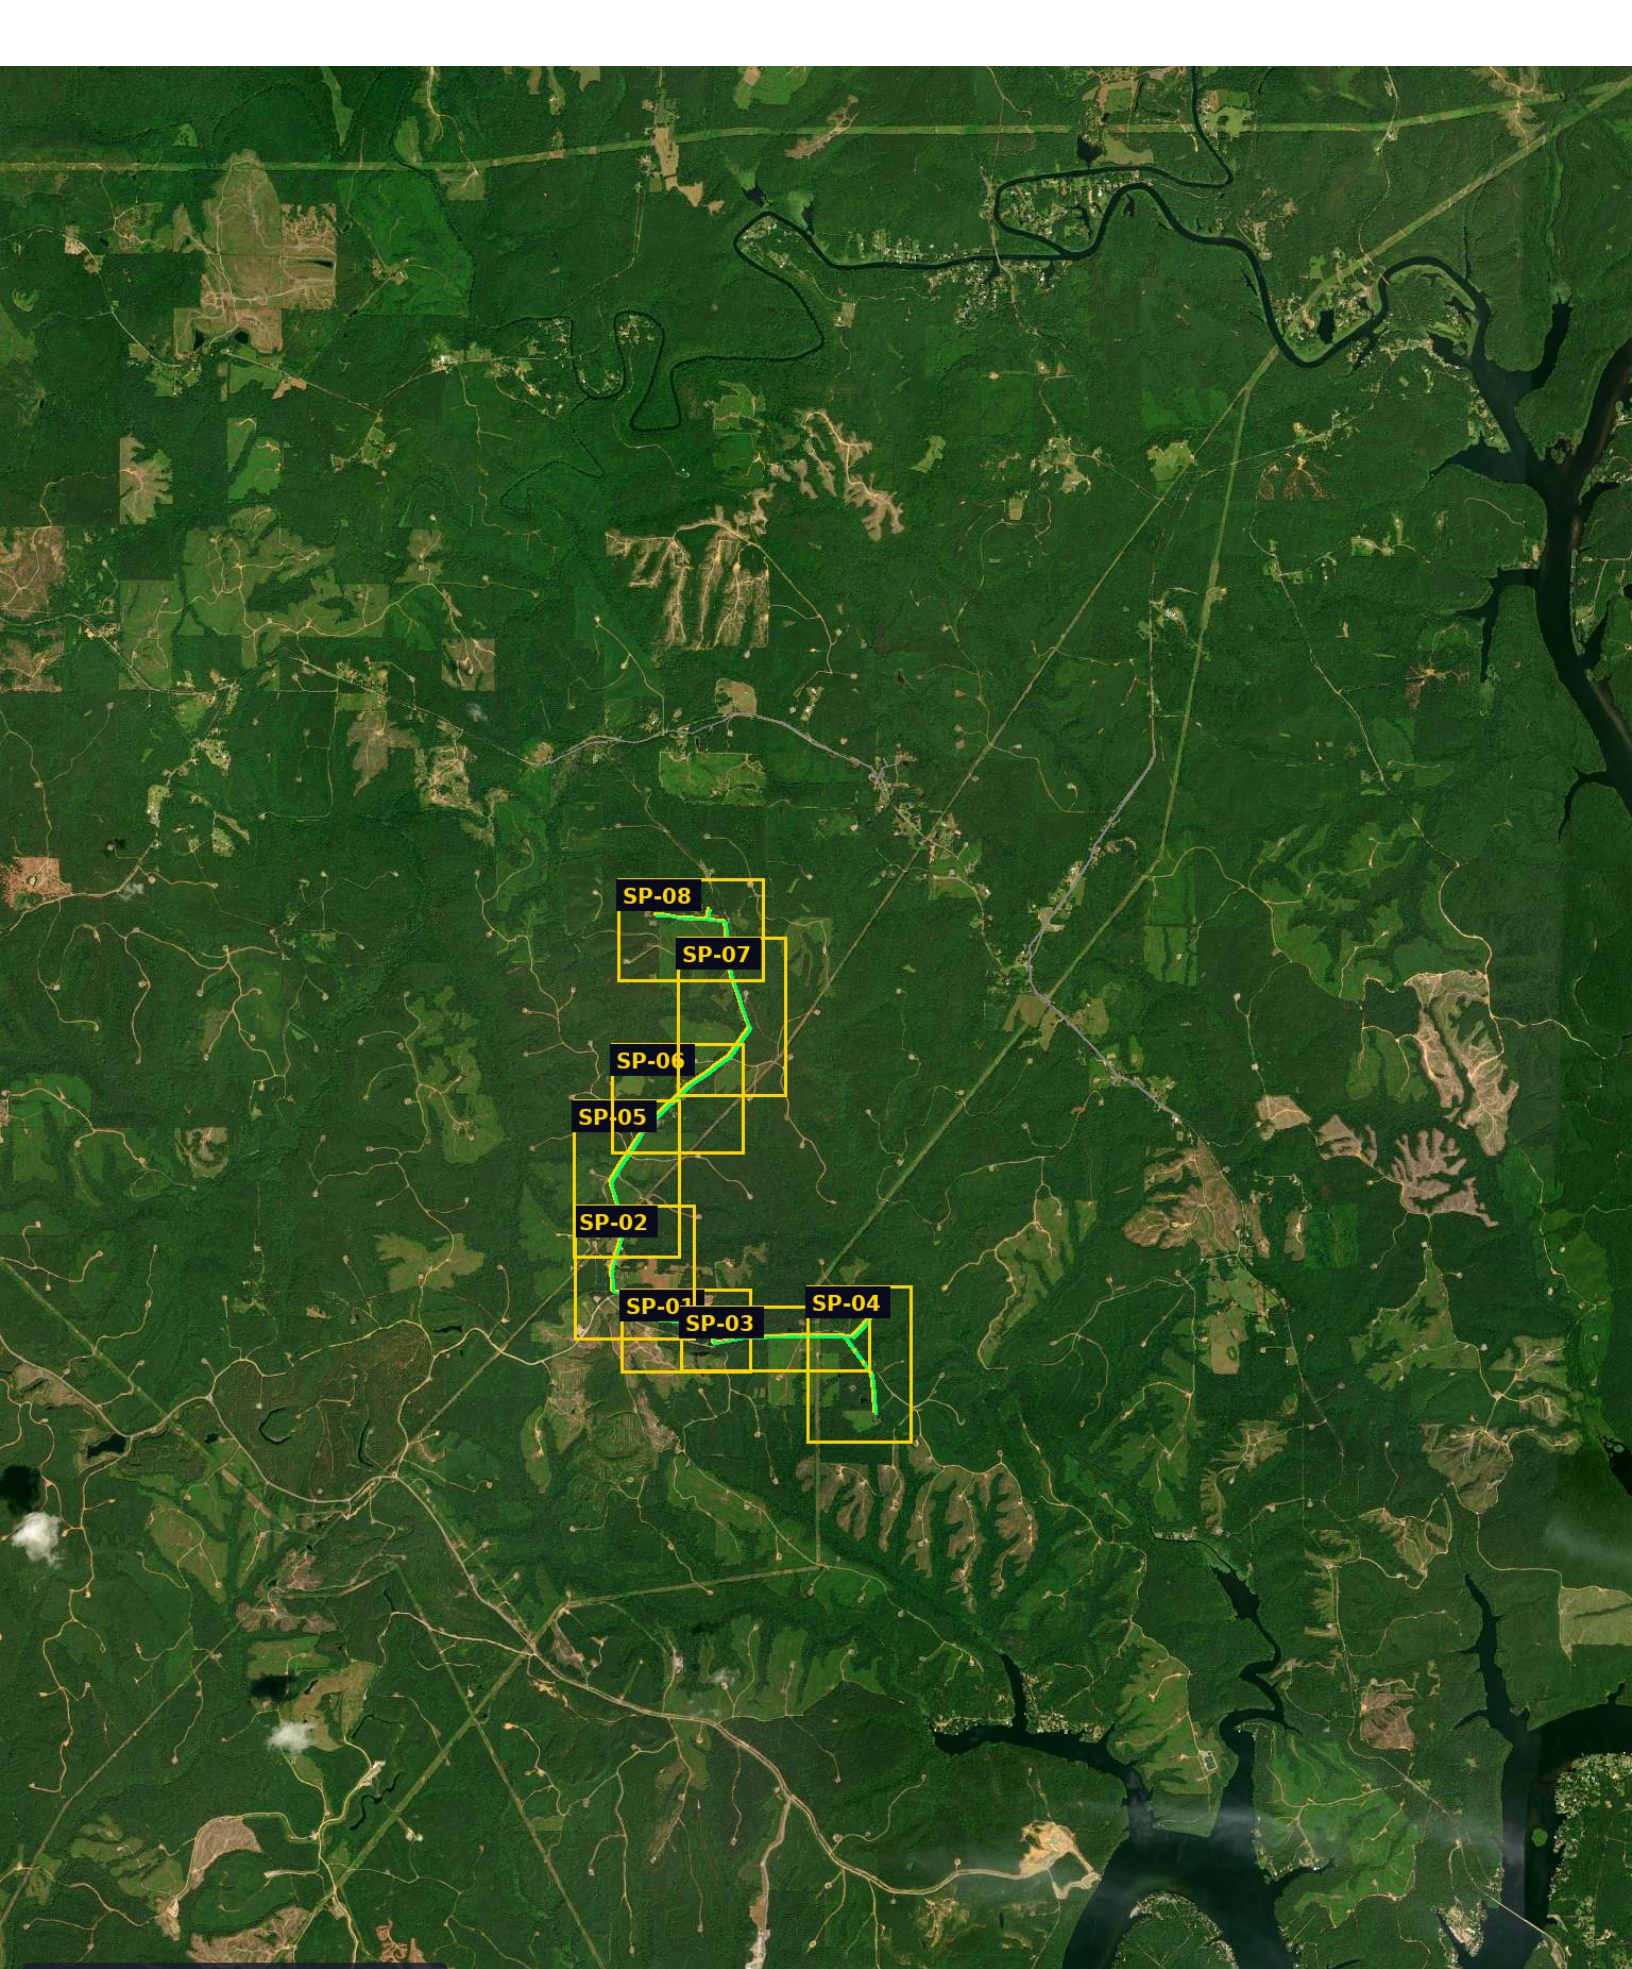


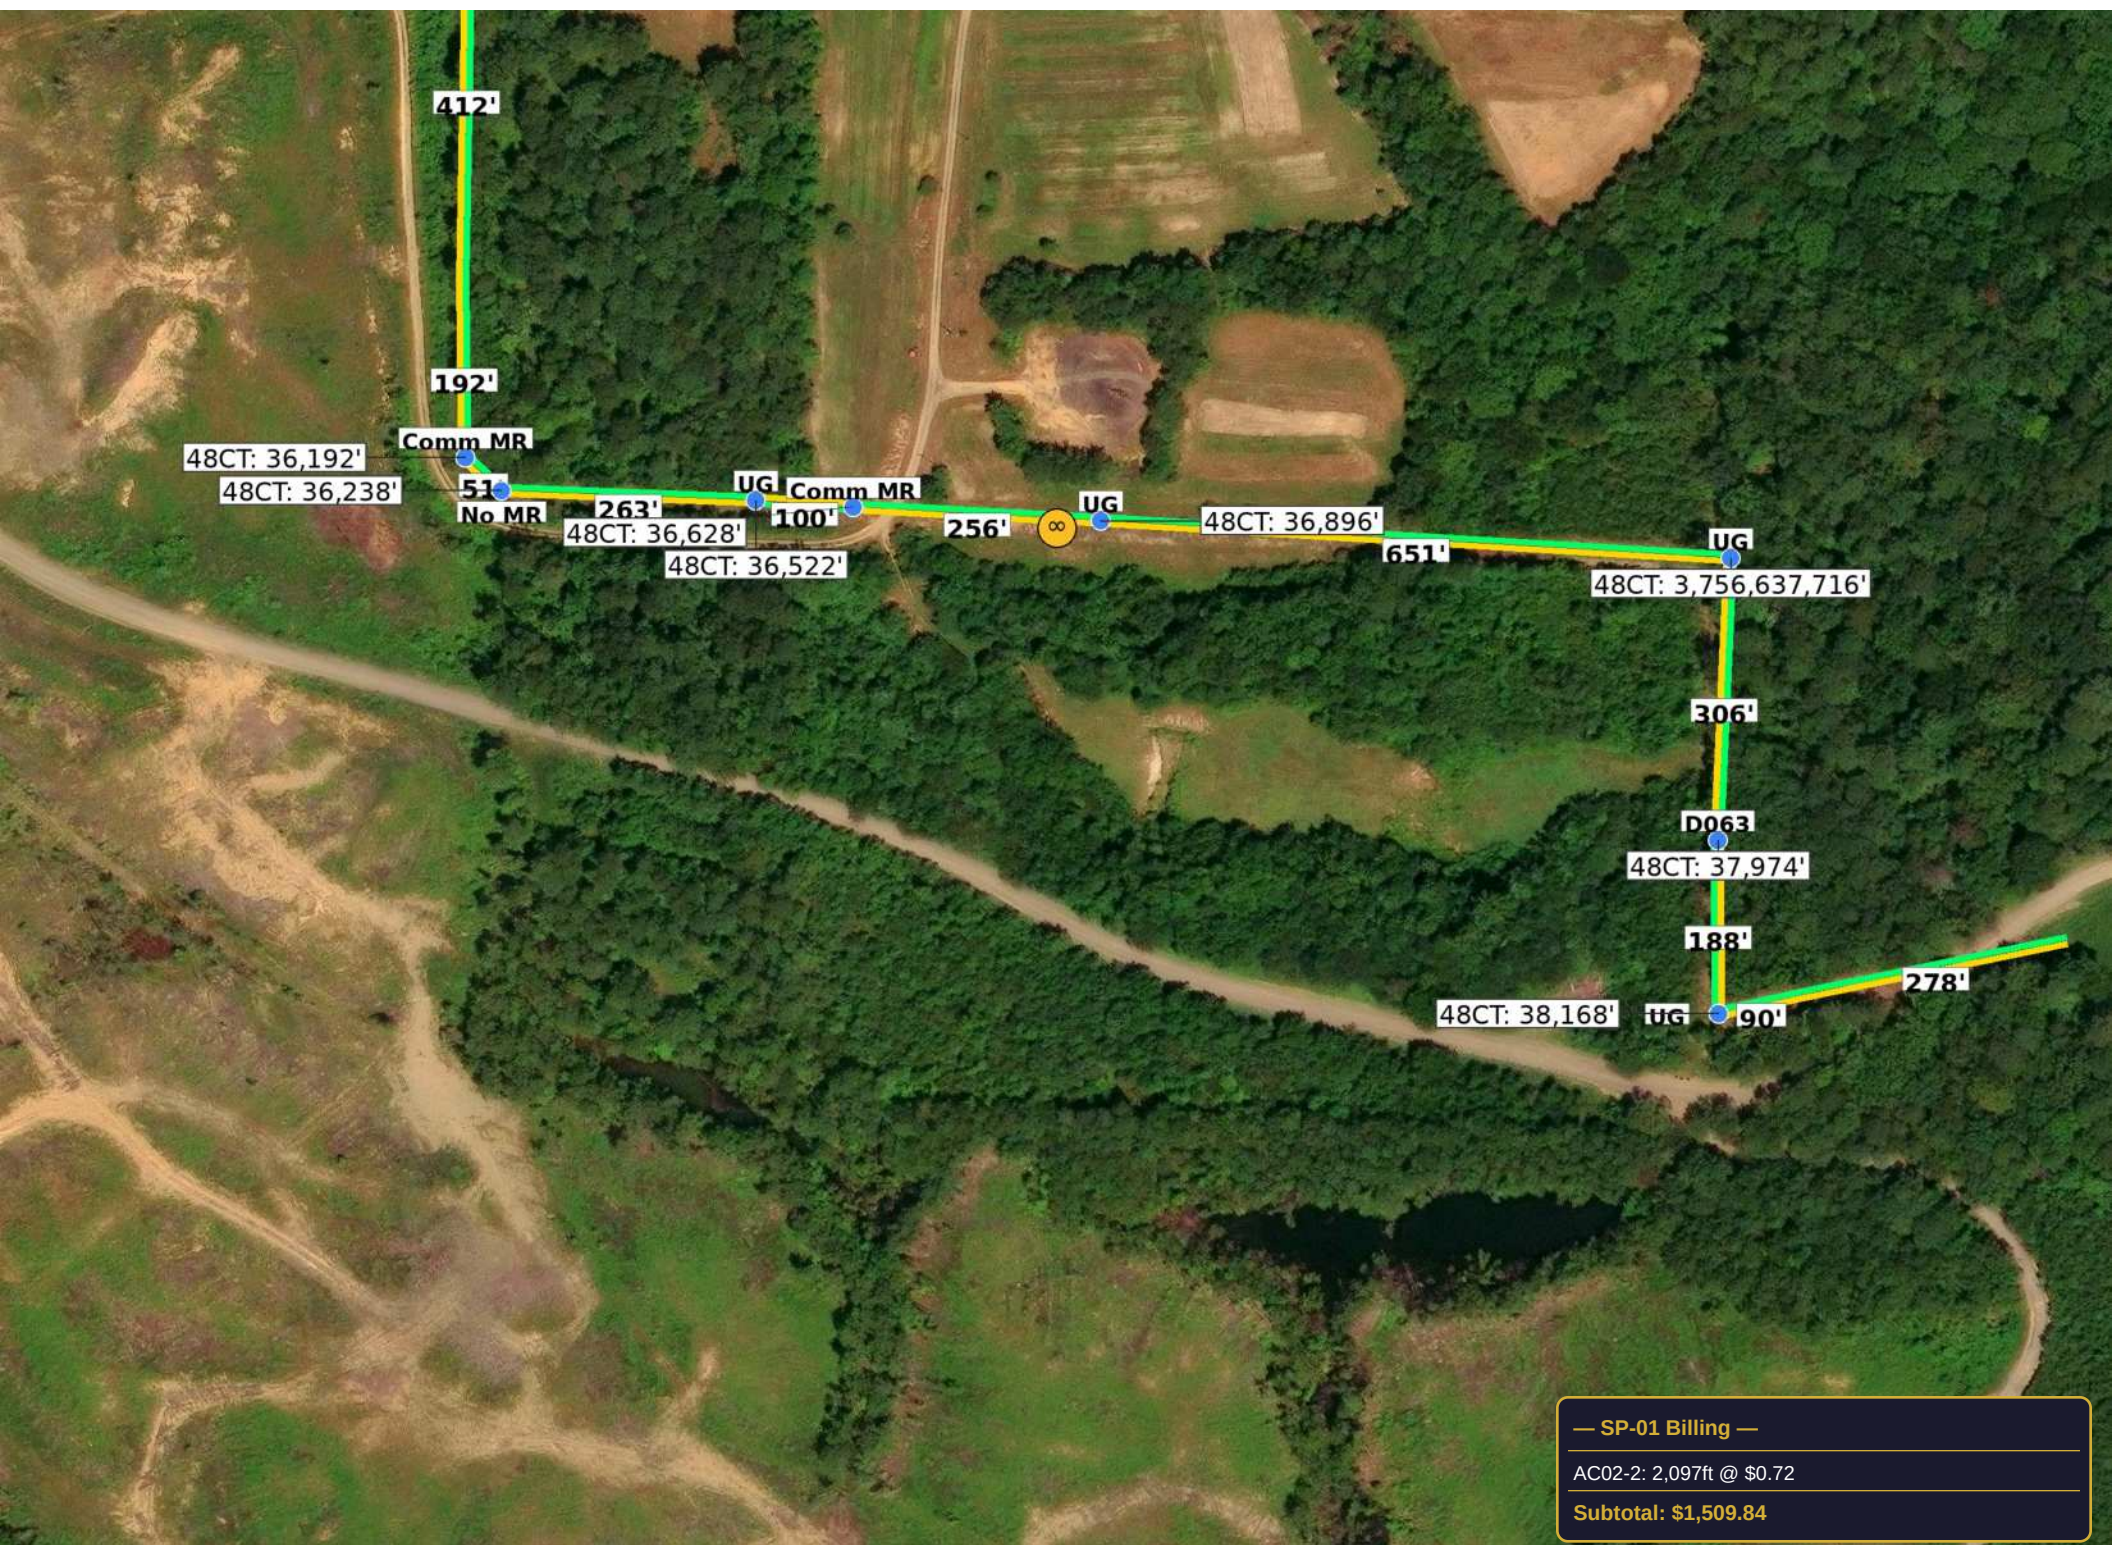

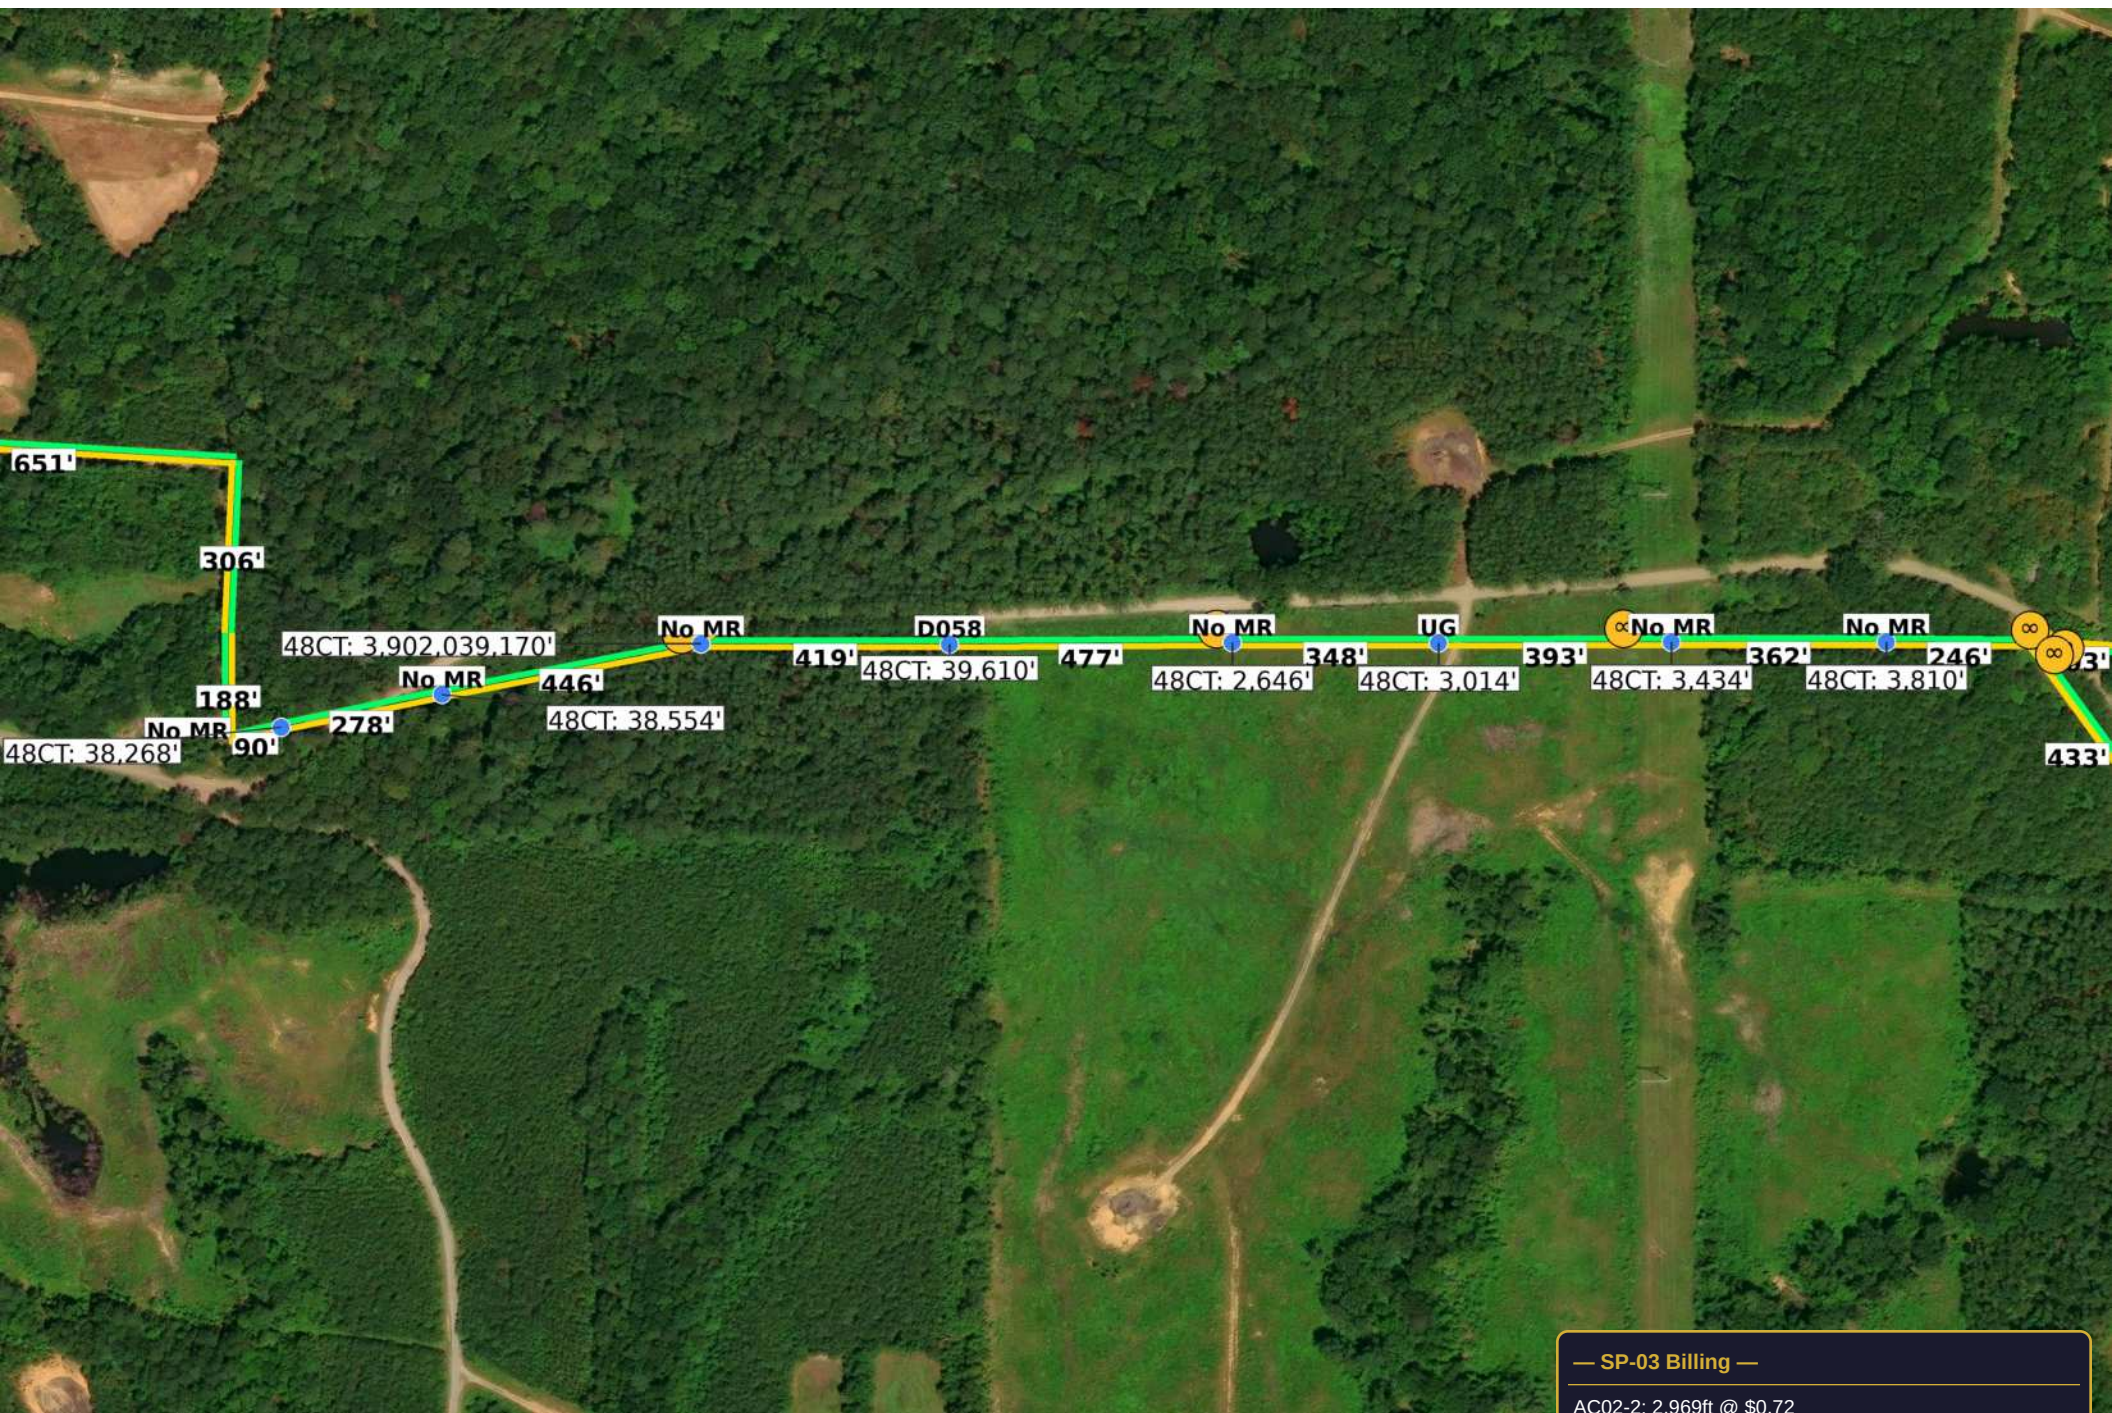


— SP-03 Billing —
AC02-2: 2,969ft @ \$0.72
Subtotal: \$2,137.68

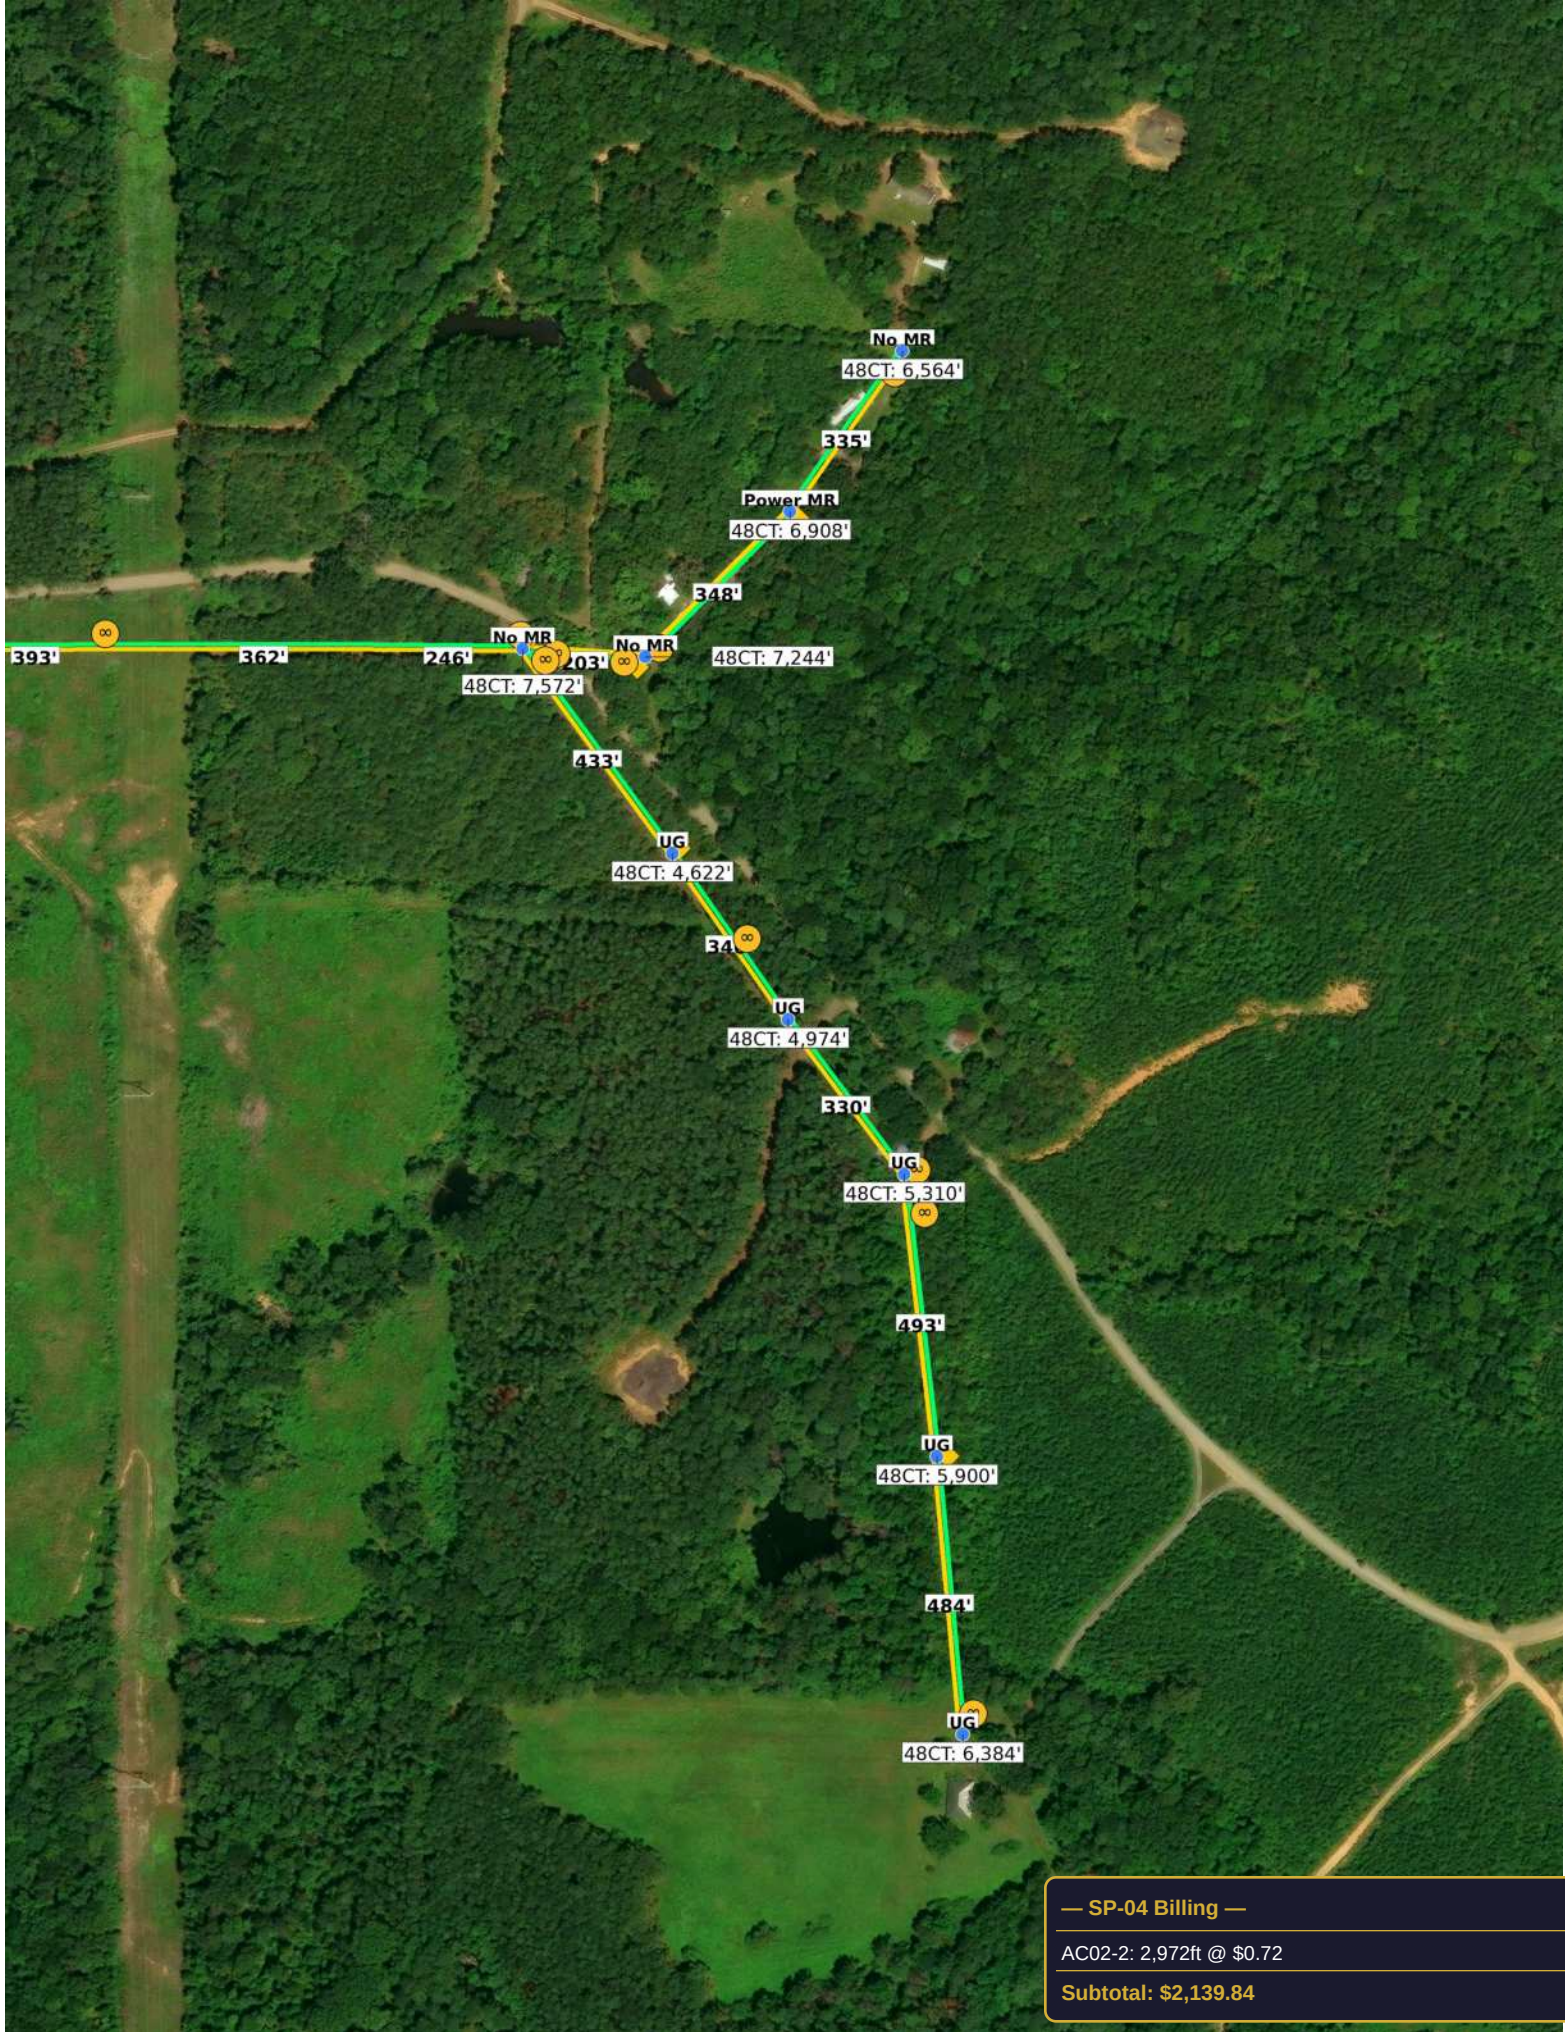


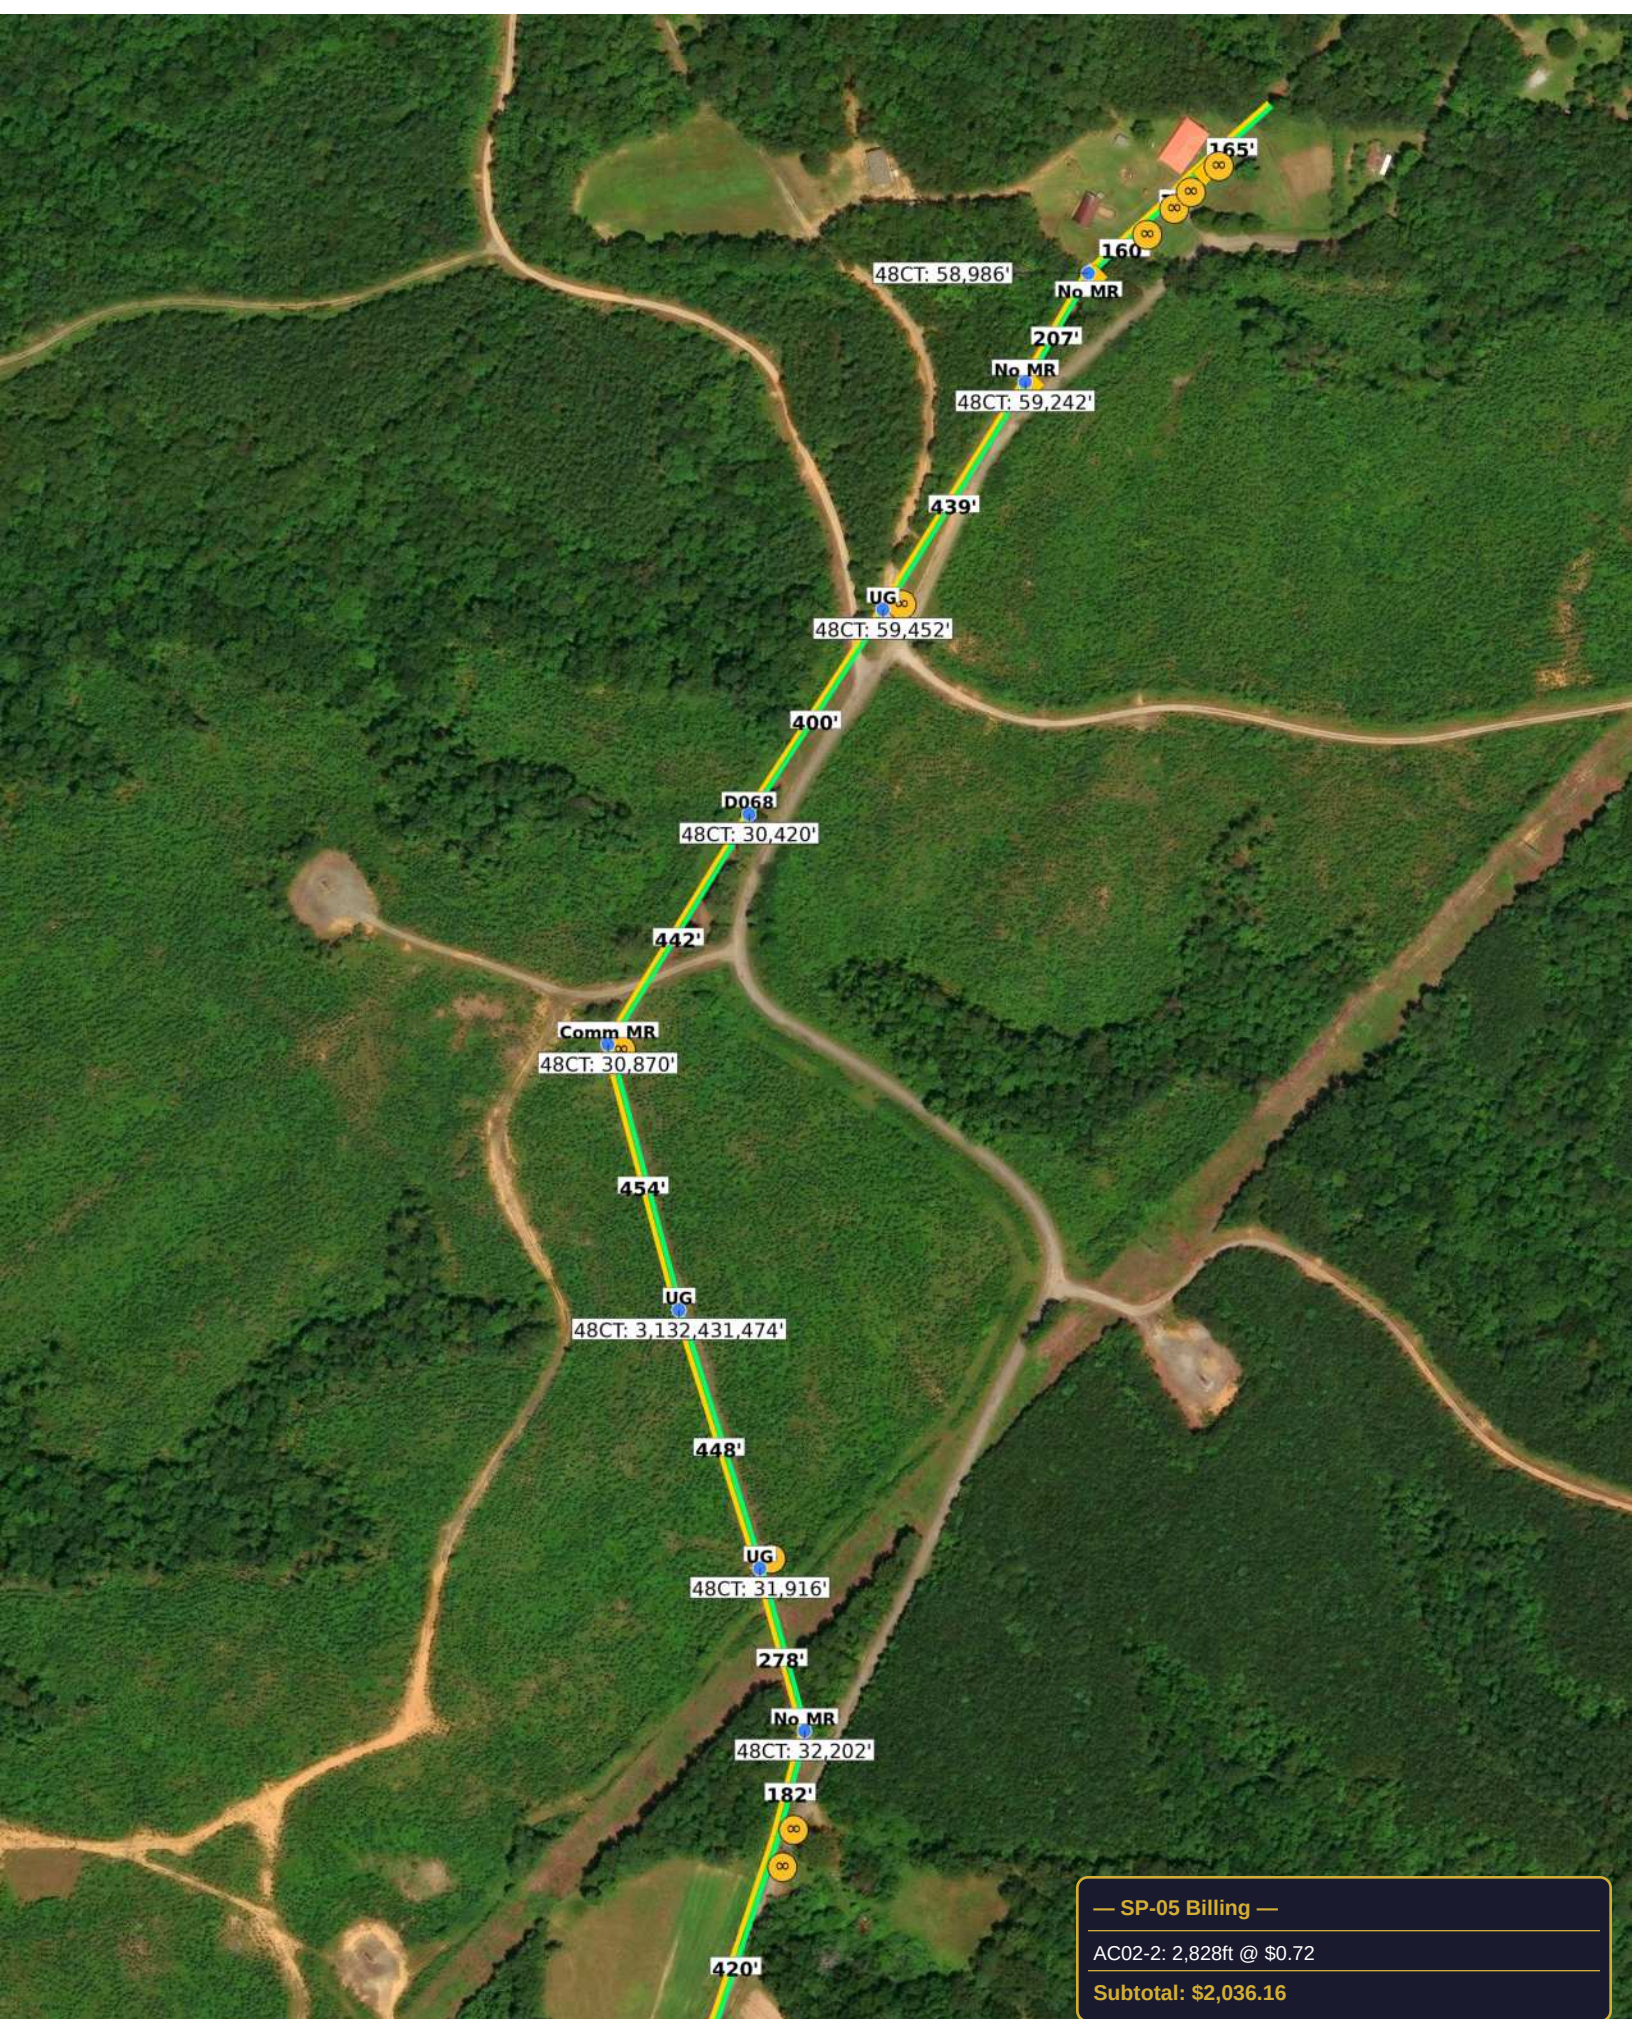



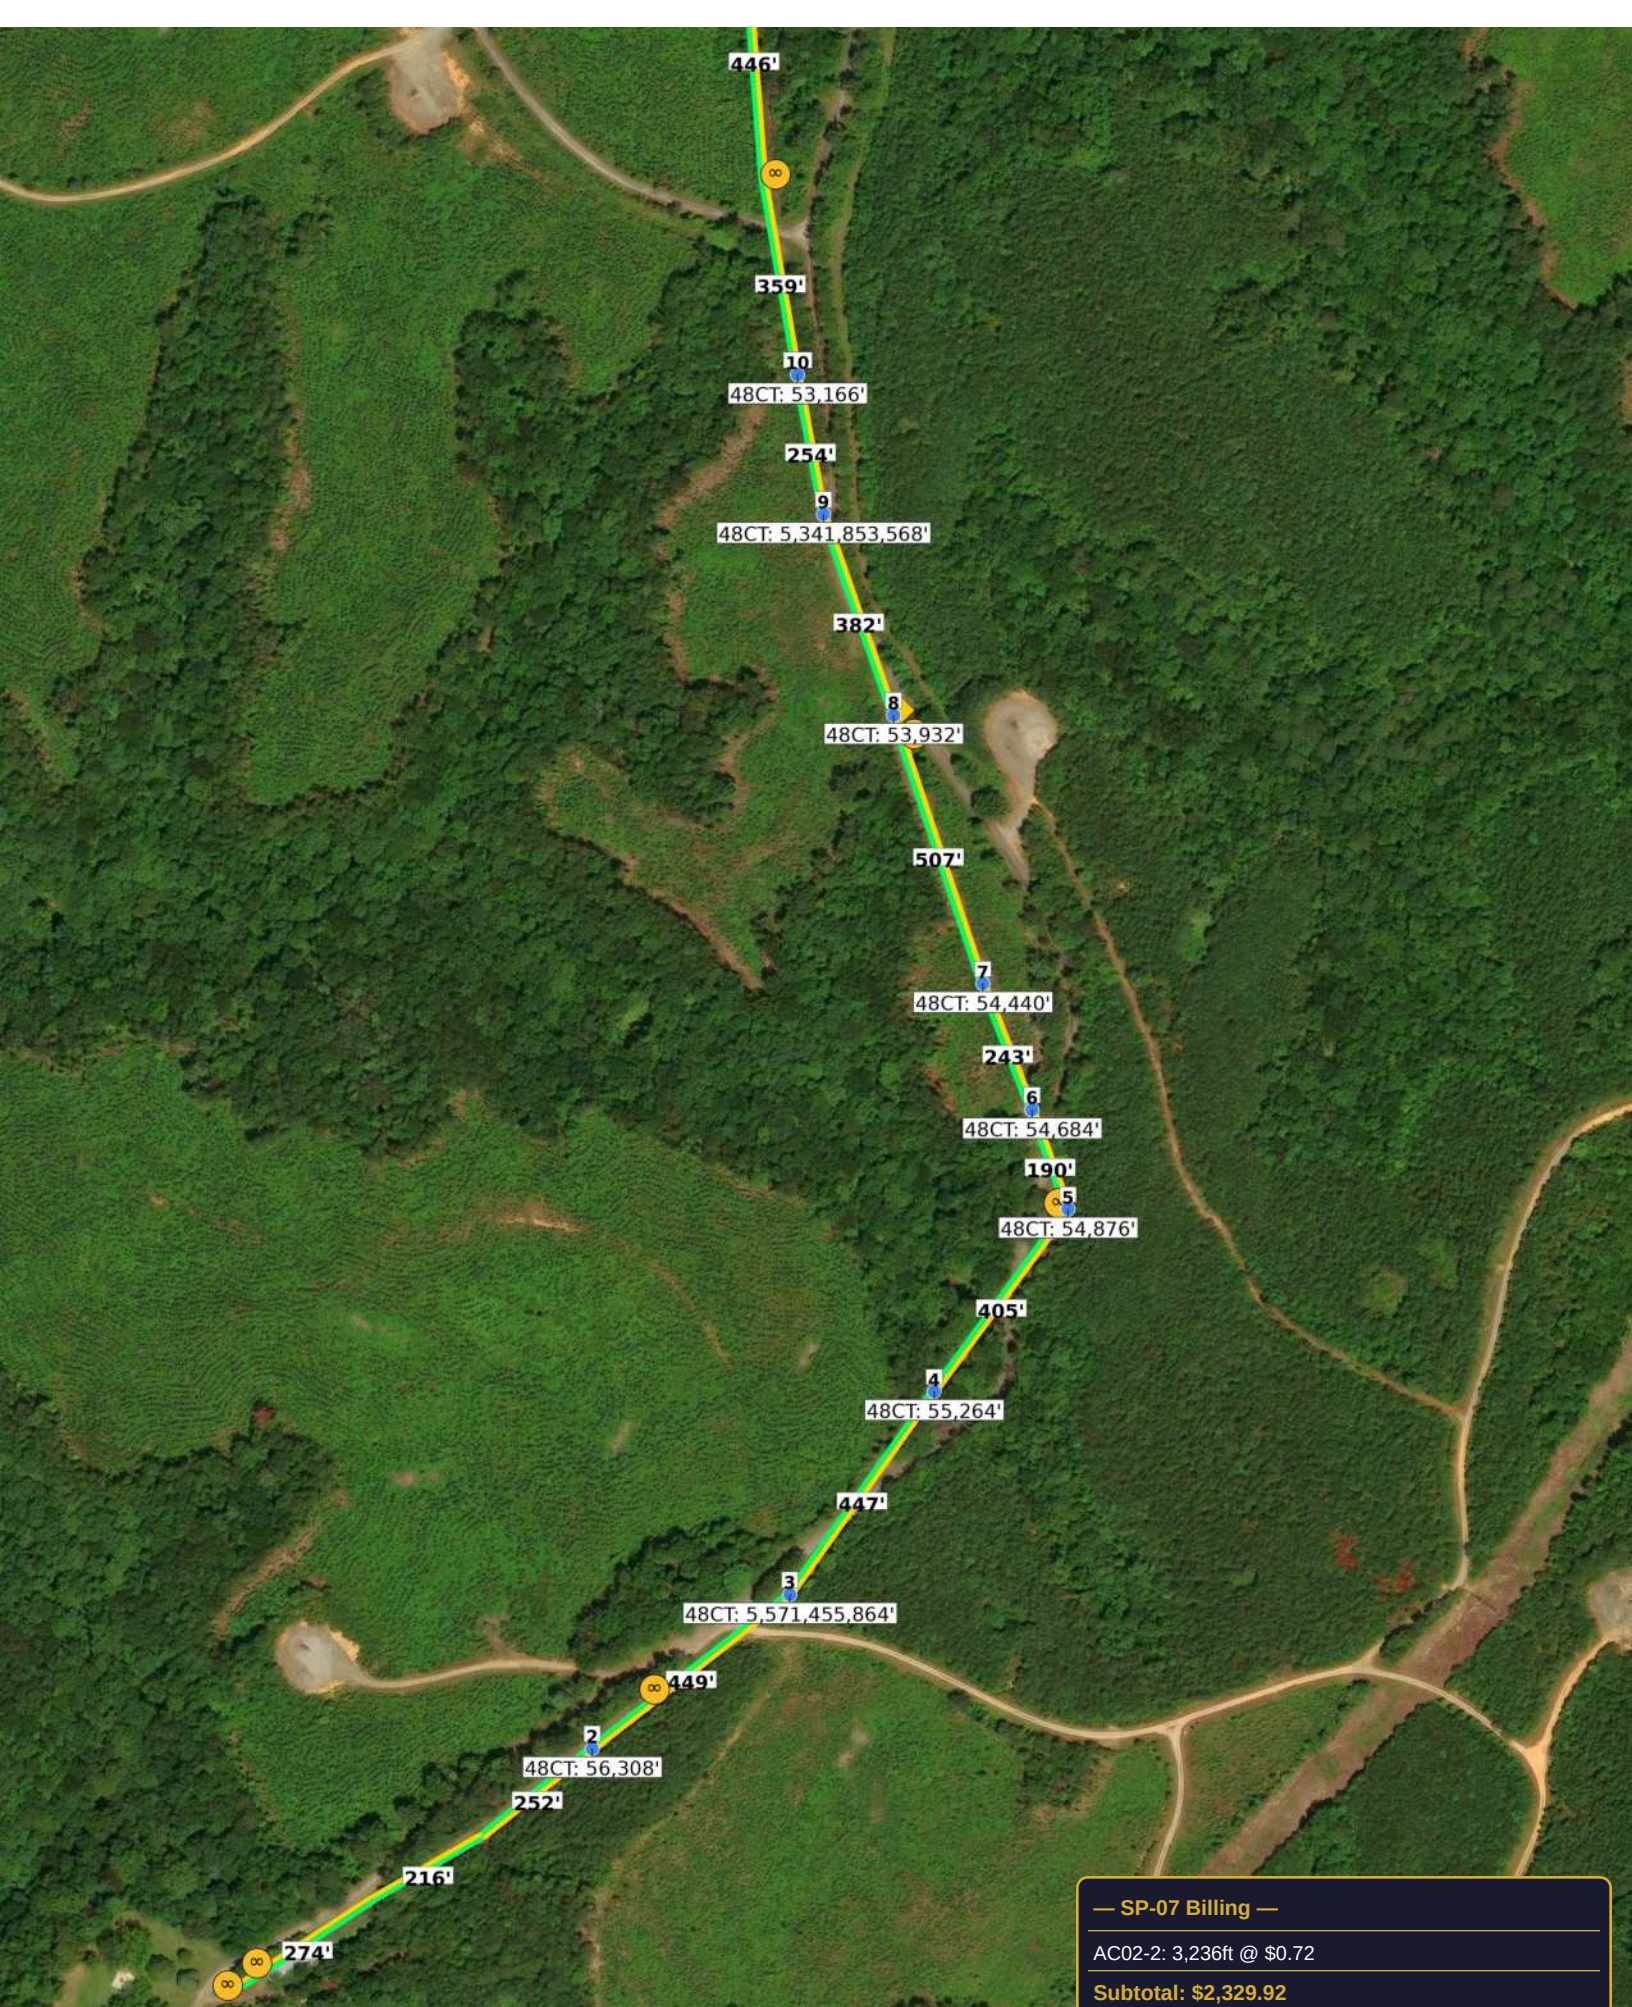

— SP-07 Billing —
AC02-2: 3,236ft @ \$0.72
Subtotal: \$2,329.92

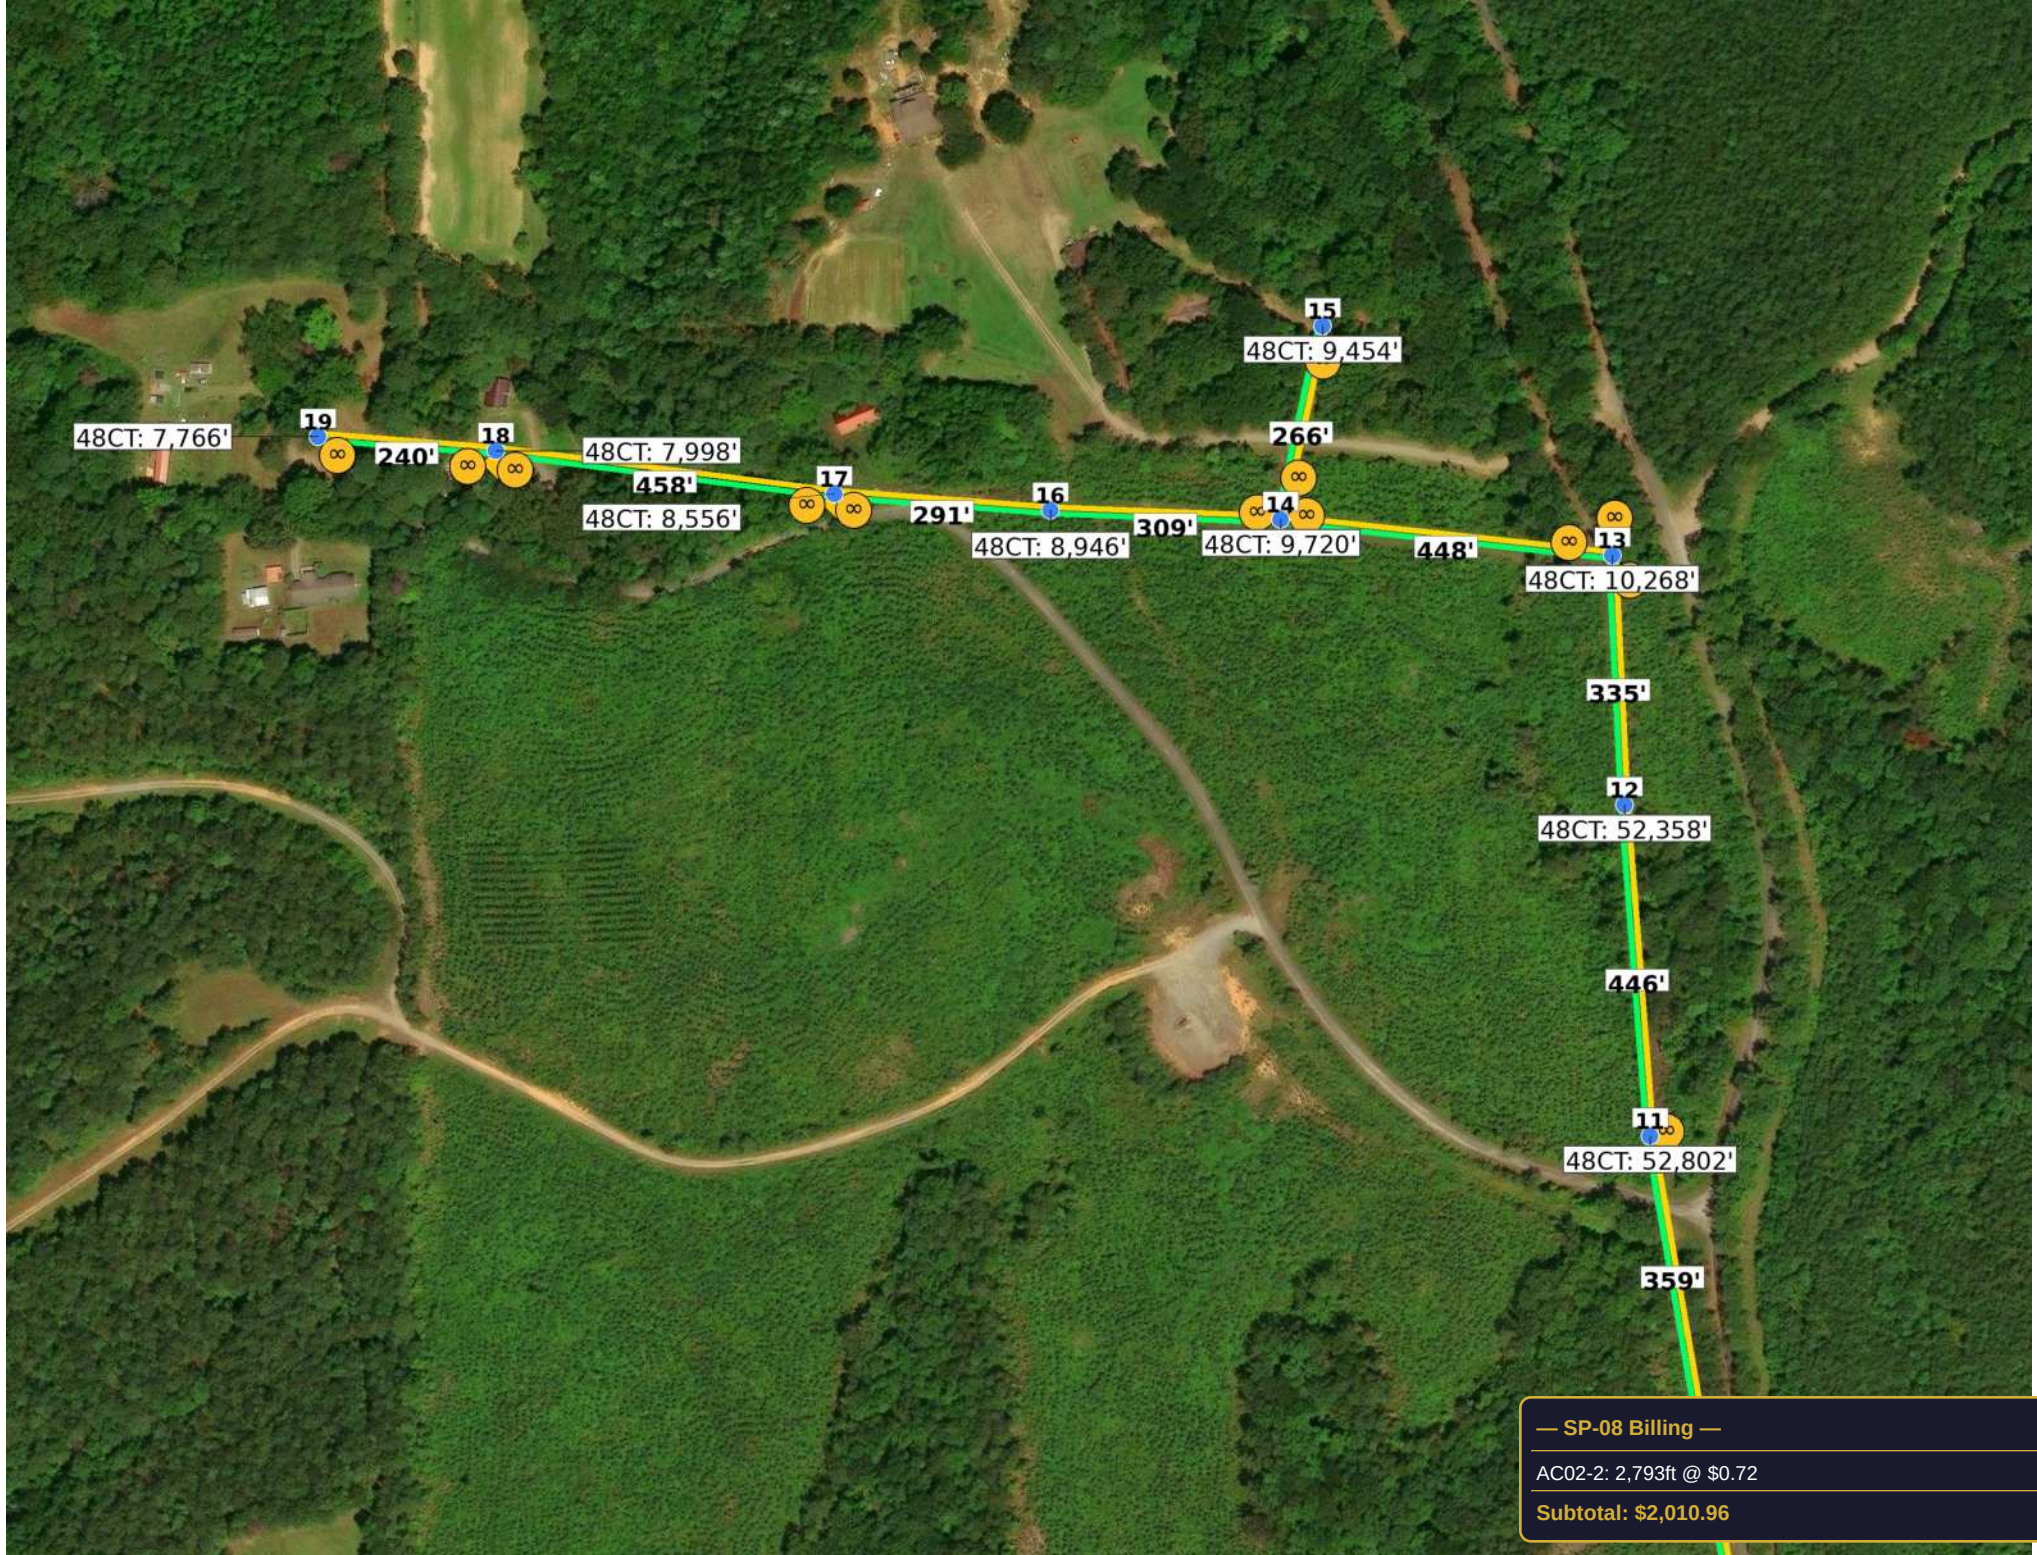

Billing Summary — SLV 407

JS17E • PID 3435037 • Week Ending August 6, 2026

Code	Description	Rate	Qty	Total
AC02-2	Fiber on Pre-Billed Strand	\$0.72/ft	22,090'	\$15,904.80
TOTAL				\$15,904.80

LEGEND

-  Lashed Span (Yellow=Strand, Green=Fiber)
-  Strand Only
-  AS02 Strand Only
-  Overlash (AS07)
-  Design Route (not yet billed)
-  MR = Make Ready and Compliance (AS18) — billed per pole

SYMBOLS

-  Pole Location
-  Fiber Tap
-  96CT/48CT Tic Mark Count